

STATE ENGINEER
Salem, Oregon

LANE 15490
Well Record
LANE
15490

STATE WELL NO. 18/21-19J
COUNTY Lane
APPLICATION NO. CR-3555

OWNER: Marvin R. Franklin


MAILING ADDRESS: Route 4, Box 166C

LOCATION OF WELL: Owner's No.

CITY AND STATE: Eugene, Oregon

NE 1/4 SE 1/4 Sec. 19 T. 18 S., R. 2 W., W.M.

Bearing and distance from section or subdivision corner 800 ft. S. and 600 ft. E. of NW corner of Thomas Whitmore donation claim

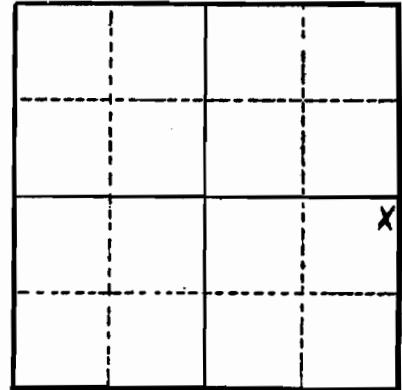

Section 19

Altitude at well

TYPE OF WELL: Driven Date Constructed 1952

Depth drilled 20 ft. Depth cased

CASING RECORD:

FINISH:

AQUIFERS:

WATER LEVEL:

14 feet below surface

PUMPING EQUIPMENT: Type Gear "1 1/2" gas Wisconsin H.P. 4
Capacity 60 G.P.M.

WELL TESTS:

Drawdown ft. after hours 60 G.P.M.

Drawdown ft. after hours G.P.M.

USE OF WATER Irrigation Temp. °F. 19

SOURCE OF INFORMATION Well Registration Statement

DRILLER or DIGGER

ADDITIONAL DATA:

Log Water Level Measurements Chemical Analysis Aquifer Test

REMARKS: