

STATE ENGINEER  
Salem, Oregon

Well Record

LANE  
15491

STATE WELL NO. 18/2W - 19J  
COUNTY LANE  
APPLICATION NO. GR. 2169

OWNER: Fremont A. Moore

MAILING ADDRESS: Rt. 4, Box 167 A.


LOCATION OF WELL: Owner's No. #2

CITY AND STATE: Eugene, Oregon

NE 1/4 SE 1/4 Sec. 19 T. 18 S., R. 2 W., W.M.

Bearing and distance from section or subdivision

corner 1135' S. and 650' E.

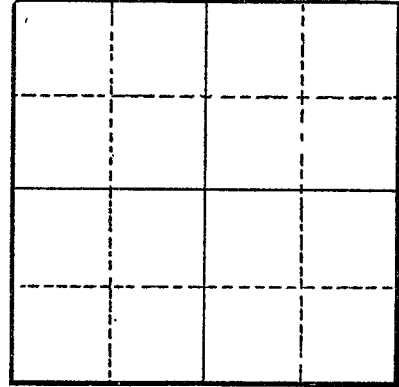

Section

Altitude at well

TYPE OF WELL: Driven Date Constructed 1950

Depth drilled 18 Depth cased 18

CASING RECORD:

1 1/2-Inch

FINISH:

Perforations from 16 to 18

AQUIFERS:

WATER LEVEL:

9-Feet

PUMPING EQUIPMENT: Type Gear 1 1/4 Inch

H.P. 2 3/4

Capacity 50 G.P.M.

WELL TESTS:

Drawdown ..... ft. after ..... hours ..... G.P.M.

Drawdown ..... ft. after ..... hours ..... G.P.M.

USE OF WATER Irrigation Temp. °F. ...., 19

SOURCE OF INFORMATION GR-2079

DRILLER or DIGGER

ADDITIONAL DATA:

Log ..... Water Level Measurements ..... Chemical Analysis ..... Aquifer Test .....

REMARKS:



Oregon Water Resources Department
725 Summer Street NE, Suite A
Salem Oregon 97301
(503) 986-0900
www.wrd.state.or.us

Application for
Well ID Number

RECEIVED BY OWRD

MAY 02 2013

SALEM, OR

Do not complete if the well already has a Well I.D Number.

I. OWNER INFORMATION

Current Owner Name (please print): Richard & Velma Nice
Mailing Address: 85528 Dilley Lane
City: Eugene State: Oregon Zip: 97405
Mailing Address (to send Well I.D.): Same as above
City: State: Zip:

II. WELL INFORMATION (Do not complete this section if the well report is attached.)

Township: (North/South) Range: (East/West) Section:
Tax Lot: 412 County: 1/4 1/4
Street Address of Well: 85528 DILLEY LN City:
Owner at time the well was constructed, (if known): Fremont A. Moore
If the property had a different street address in the past:

III. GENERAL WELL INFORMATION (Do not complete this section if the well report is attached)

Use of Well (domestic, irrigation, commercial, industrial, monitoring):
Date Well Constructed: Total Well Depth: Casing Diameter:
Other Information:

SUBMITTED BY (please print): Richard Nice
PHONE: 541-747-2310 FAX:
Cell 541-913-7238

Send application to Oregon Water Resources Department; 725 Summer St NE, Suite A; Salem, Oregon 97301-1266; fax (503) 986-0902. Applications are processed and Well I.D. Numbers are mailed every Wednesday.

For Official Use Only by the Oregon Water Resources Department:

Received Date:

5-2-13

Well Log Number:

LANE15491

Well Identification #:

L 111865

\*OWRD Staff Notes: Per WR GR-2169 well address same as LO mailing at TL 412.