

STATE ENGINEER
Salem, Oregon

LANE 15500
Well Record

LANE
15500


STATE WELL NO. 18/2W - 20M
COUNTY LANE
APPLICATION NO. GR-2168

OWNER: Fremont A. Moore
MAILING ADDRESS: Rt. 4, Box 167 A.

LOCATION OF WELL: Owner's No. #1
CITY AND STATE: Eugene, Oregon

N. 1/4 SW 1/4 Sec. 20 T. 18 S., R. 2 W., W.M.

Bearing and distance from section or subdivision corner 1115' S. and 1050' E.

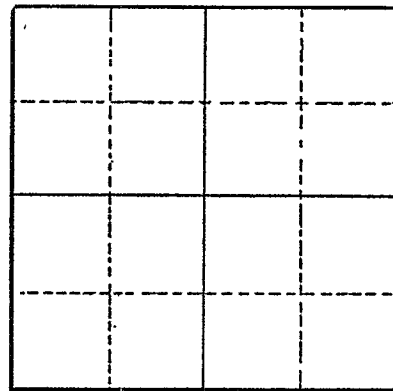

Section

Altitude at well

TYPE OF WELL: Driven Date Constructed 1946

Depth drilled 18 Depth cased 18

CASING RECORD:

1 1/4-Inches

FINISH:

Perforations from 16 to 18

AQUIFERS:

WATER LEVEL:

9-Feet

PUMPING EQUIPMENT: Type Gear 1 1/4 Inch H.P. 4
Capacity 50 G.P.M.

WELL TESTS:

Drawdown ft. after hours G.P.M.
Drawdown ft. after hours G.P.M.

USE OF WATER Irrigation Temp. °F., 19

SOURCE OF INFORMATION GR-2078

DRILLER or DIGGER

ADDITIONAL DATA:

Log Water Level Measurements Chemical Analysis Aquifer Test

REMARKS:



Oregon Water Resources Department
725 Summer Street NE, Suite A
Salem Oregon 97301
(503) 986-0900
www.wrd.state.or.us

Application for
Well ID Number

RECEIVED BY OWRD

MAY 02 2013

Do not complete if the well already has a Well I.D Number.

SALEM, OR

I. OWNER INFORMATION

Current Owner Name (please print): Richard + Velma Nice
Mailing Address: 85528 Dilley Lane
City: Eugene State: Oregon Zip: 97405
Mailing Address (to send Well I.D.): SAME AS ABOVE
City: State: Zip:

II. WELL INFORMATION (Do not complete this section if the well report is attached.)

Township: (North/South) Range: (East/West) Section:
Tax Lot: County: 1/4 1/4
Street Address of Well: City:
Owner at time the well was constructed, (if known): Fremont A. Moore
If the property had a different street address in the past:

III. GENERAL WELL INFORMATION (Do not complete this section if the well report is attached)

Use of Well (domestic, irrigation, commercial, industrial, monitoring):
Date Well Constructed: Total Well Depth: Casing Diameter:
Other Information:

SUBMITTED BY (please print): Richard Nice
PHONE: 541-747-2310 FAX:
cell 541-913-7238

Send application to Oregon Water Resources Department; 725 Summer St NE, Suite A; Salem, Oregon 97301-1266; fax (503) 986-0902. Applications are processed and Well I.D. Numbers are mailed every Wednesday.

For Official Use Only by the Oregon Water Resources Department:

Received Date: 5-2-13 Well Log Number: LANE 15500 Well Identification #: L111864