

STATE ENGINEER  
Salem, Oregon

# Well Record

STATE WELL NO. 18/2W-22H  
COUNTY LANE  
APPLICATION NO. GR-2969

OWNER: Raymond F. Hills


MAILING ADDRESS: Rt. 2, Box 580

LOCATION OF WELL: Owner's No. \_\_\_\_\_

CITY AND STATE: Creswell, Oregon

SE 1/4 NE 1/4 Sec. 22 T. 18 S., R. 2 W., W.M.

Bearing and distance from section or subdivision corner N. 12° 20' E. 1170.1' to N.E. corner John Shelley DLC #71.

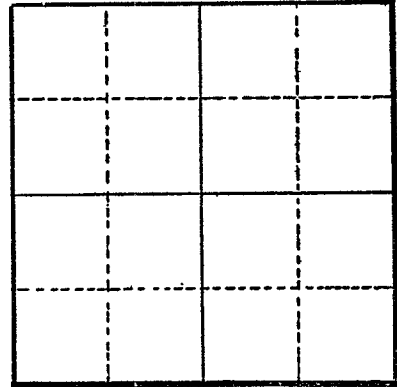

Section \_\_\_\_\_

Altitude at well \_\_\_\_\_

TYPE OF WELL: dug Date Constructed 1948

Depth drilled 13 Depth cased \_\_\_\_\_

CASING RECORD:

10-inch

FINISH:

AQUIFERS:

Top soil, River-run gravel

WATER LEVEL:

2 - 6 feet

PUMPING EQUIPMENT: Type Pacific Centrifugal H.P. 3  
Capacity 30 G.P.M.

WELL TESTS:

Drawdown no ft. after \_\_\_\_\_ hours Pumping 30 in spring G.P.M.  
Drawdown total ft. after \_\_\_\_\_ hours Pumping 30 in late summer G.P.M.

USE OF WATER irrigation Temp. \_\_\_\_\_ °F., 19 \_\_\_\_\_

SOURCE OF INFORMATION GR-2784

DRILLER or DIGGER \_\_\_\_\_

ADDITIONAL DATA:

Log  Water Level Measurements \_\_\_\_\_ Chemical Analysis \_\_\_\_\_ Aquifer Test \_\_\_\_\_

REMARKS:

Top soil 2 --  
River-run gravel from soil down to depth unknown