

STATE ENGINEER
Salem, Oregon

Well Record **LANE** STATE WELL NO. 18/2W-22M
15568 COUNTY Lane
APPLICATION NO. GR-3553

OWNER: C. V. Holbrook

MAILING

ADDRESS:

CITY AND

STATE: Creswell, Oregon


LOCATION OF WELL: Owner's No.

NW 1/4 SW 1/4 Sec. 22 T. 18 S., R. 2 W., W.M.

Bearing and distance from section or subdivision

corner S. 68° 30' E. 480 ft. from W 1/4 corner

Sec. 22

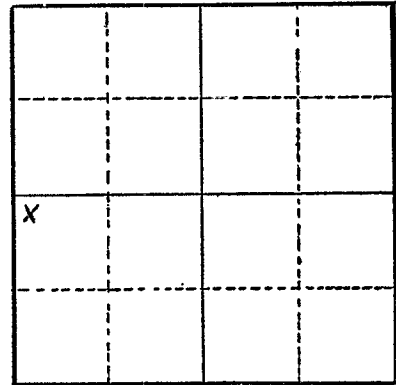

Section 22

Altitude at well

TYPE OF WELL: Driven Date Constructed June, 1945

Depth drilled 21 feet Depth cased 21 feet

CASING RECORD:

3 inch casing set to 21 feet

FINISH:

AQUIFERS:

WATER LEVEL:

10 feet below surface

PUMPING EQUIPMENT: Type 1 1/2 inch electric H.P. 5
Capacity 70 G.P.M.

WELL TESTS:

Drawdown ft. after hours G.P.M.

Drawdown ft. after hours G.P.M.

USE OF WATER Irrigation Temp. °F. 19

SOURCE OF INFORMATION Well Registration Statement

DRILLER or DIGGER C. V. Holbrook

ADDITIONAL DATA:

Log Water Level Measurements Chemical Analysis Aquifer Test

REMARKS: