

STATE ENGINEER  
Salem, Oregon


Well Record **LANE** STATE WELL NO. 18/2W-22P  
**15569** COUNTY LANE  
APPLICATION NO. GR-2462

OWNER: Frank Shelley MAILING ADDRESS: Rt. 2, Box 787

LOCATION OF WELL: Owner's No. CITY AND STATE: Creswell, Oregon

SE 1/4 SW 1/4 Sec. 22 T. 18 S, R. 2 W., W.M.

Bearing and distance from section or subdivision corner 1010' N. and 260' W.

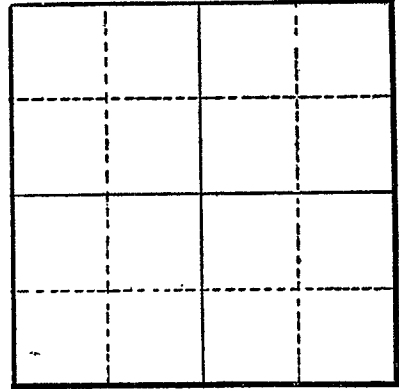

Section .....

Altitude at well .....

TYPE OF WELL: Dug Date Constructed 1951

Depth drilled 14 Depth cased .....

CASING RECORD:

FINISH:

AQUIFERS:

Dirt and rock

WATER LEVEL:

12-feet

PUMPING EQUIPMENT: Type Berkley H.P. 25

Capacity 500 G.P.M.

WELL TESTS:

Drawdown 3 ft. after ..... hours Pumping 500 G.P.M.

Drawdown 5 ft. after ..... hours Pumping 500 G.P.M.

USE OF WATER Irrigation Temp. °F. ...., 19

SOURCE OF INFORMATION GR-2332

DRILLER or DIGGER .....

ADDITIONAL DATA:

Log X Water Level Measurements ..... Chemical Analysis ..... Aquifer Test .....

REMARKS:

Dirt 7 7  
Cement, rock 7 0