

STATE ENGINEER
Salem, Oregon

Well Record

LANE
15693

STATE WELL NO. 18/2W-26F
COUNTY LANE
APPLICATION NO. GR-3146

OWNER: Joe Zybach & Lyla J Zybach


MAILING ADDRESS: 344 N 36

LOCATION OF WELL: Owner's No.

CITY AND STATE: Springfield, Oregon

SE 1/4 NW 1/4 Sec. 26 T. 18 S., R. 2 W., W.M.

Bearing and distance from section or subdivision corner 316.7' E from NW corner of James G Mitchell DLC No 68 (150' S to Well)

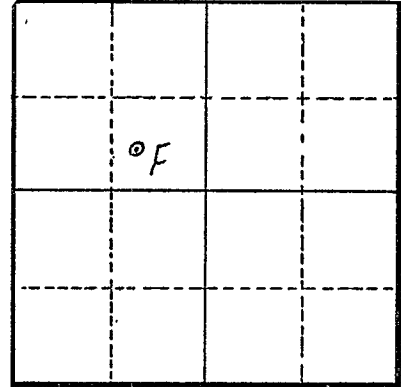

Section 26

Altitude at well

TYPE OF WELL: Drilled Date Constructed 1953

Depth drilled 96' Depth cased 17'

CASING RECORD:

5-inch

FINISH:

AQUIFERS: Sand & Gravel
Basalt Lava

WATER LEVEL:

15'

PUMPING EQUIPMENT: Type submersible pump H.P. 1/2

Capacity 8 1/2 G.P.M.

WELL TESTS:

Drawdown ft. after hours 22 1/2 G.P.M.

Drawdown ft. after hours G.P.M.

USE OF WATER Irrigation Temp. °F. 19

SOURCE OF INFORMATION GR-3855

DRILLER or DIGGER Klons Well Drilling

ADDITIONAL DATA:

Log Water Level Measurements Chemical Analysis Aquifer Test

REMARKS:

Sand & Gravel 17' to 17'
Basalt Lava 79' to 79'