

STATE ENGINEER
Salem, Oregon

Well Record

LANE
15694

STATE WELL NO. 18/2W-26Q
COUNTY Lane
APPLICATION NO. GR-3192

OWNER: James T. Wampler

MAILING
ADDRESS: Route 2, Box 610

LOCATION OF WELL: Owner's No.

CITY AND
STATE: Creswell, Oregon

SW $\frac{1}{4}$ SE $\frac{1}{4}$ Sec. 26 T. 18 N. S. R. 2 E. W., W.M.

Bearing and distance from section or subdivision

corner 600' N. and 2460' W.


Altitude at well

TYPE OF WELL: pond Date Constructed 1941

Depth drilled 14 Depth cased

CASING RECORD:

36"

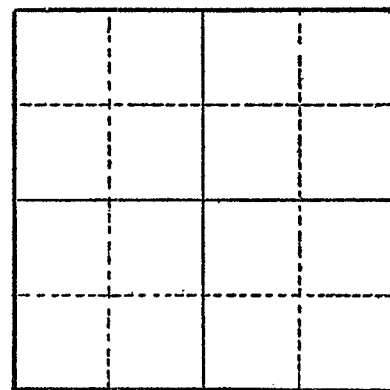

Section

FINISH:

AQUIFERS:

WATER LEVEL:

PUMPING EQUIPMENT: Type Homart Gasoline 2" x 1 $\frac{1}{2}$ H.P. 2 $\frac{1}{2}$
Capacity 50 G.P.M.

WELL TESTS:

Drawdown ft. after hours G.P.M.

Drawdown ft. after hours G.P.M.

USE OF WATER Irrigation Temp. °F. 19

SOURCE OF INFORMATION GR-2973

DRILLER or DIGGER

ADDITIONAL DATA:

Log Water Level Measurements Chemical Analysis Aquifer Test

REMARKS: