

STATE ENGINEER
Salem, Oregon

OBSERVATION WELL

Well Record

STATE WELL NO. 18/2W-27F
COUNTY Lane
APPLICATION NO. GR-4087

OWNER: Geo. I. & Marion Potter

MAILING

ADDRESS: Rt. 2, Box 790

CITY AND


STATE: Creswell, Oregon

LOCATION OF WELL: Owner's No.

SE 1/4 NW 1/4 Sec. 27 T. 18 S., R. 2 W., W.M.

Bearing and distance from section or subdivision

corner 1520' S. & 1700' E. from NW Cor. Sec. 27

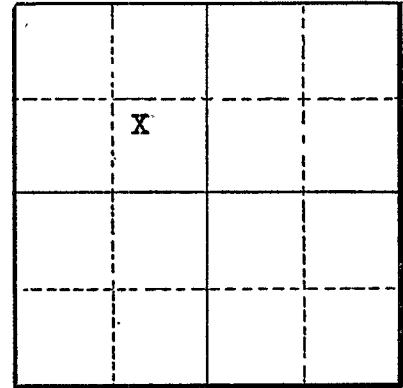

Altitude at well

TYPE OF WELL: Drilled Date Constructed 9/52

Depth drilled 115 ft. Depth cased 60 ft.

Section 27

CASING RECORD:

8 inch casing set from surface to approximately 60 feet

FINISH:

AQUIFERS:

WATER LEVEL:

12 feet below surface

PUMPING EQUIPMENT: Type Fairbanks Morse turbine H.P. 7 1/2
Capacity 120 G.P.M.

WELL TESTS:

Drawdown ft. after hours G.P.M.

Drawdown ft. after hours G.P.M.

USE OF WATER Irrigation Temp. °F., 19.

SOURCE OF INFORMATION Well Registration Statement Cert. # GR-3680

DRILLER or DIGGER Casey Jones Drilling Co.

ADDITIONAL DATA:

Log Water Level Measurements Chemical Analysis Aquifer Test

REMARKS: