

STATE ENGINEER
Salem, Oregon

Well Record

STATE WELL NO. 18/2W-29J(1)
Lane
COUNTY
15844 APPLICATION NO. GR-103

OWNER: Lon C. Goodwin & Beulah


MAILING ADDRESS: RFD 2, Box 374

LOCATION OF WELL: Owner's No. 1

CITY AND STATE: Creswell, Oregon

NE 1/4 SE 1/4 Sec. 29 T. 18 N. S., R. 2 E. W., W.M.

Bearing and distance from section or subdivision corner 1150' W. & 2000' N. from SE cor. Sec. 29

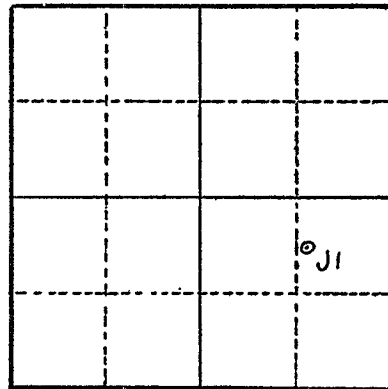

Altitude at well 550 ft. Interpolated

TYPE OF WELL: drilled Date Constructed Nov. 1954

Depth drilled 135 ft. Depth cased unknown

Section 29

CASING RECORD: unknown

FINISH: unknown

AQUIFERS: unknown

WATER LEVEL: 35 ft. below land surface

PUMPING EQUIPMENT: Type H.P.
Capacity G.P.M.

WELL TESTS:

Drawdown ft. after hours G.P.M.

Drawdown ft. after hours G.P.M.

USE OF WATER irrigation 5 acres Temp. °F. 19

SOURCE OF INFORMATION Reg. St. GR-103

DRILLER or DIGGER Casey Jones Well Drilling Co.

ADDITIONAL DATA:

Log Water Level Measurements Chemical Analysis Aquifer Test

REMARKS: