

STATE ENGINEER
Salem, Oregon

Well Record

STATE WELL NO. 18/2W-36
COUNTY LANE
APPLICATION NO. GR-2601

16069

OWNER: Paul D. Green


MAILING ADDRESS: Star Route

LOCATION OF WELL: Owner's No.

CITY AND STATE: Dexter, Oregon

NW¹/₄ SW ¹/₄ SE ¹/₄ Sec. 36 T. 18 S, R. 2 W, W.M.

Bearing and distance from section or subdivision corner W. 1127' from the Abel K. Bristow D.C. 67 then N. 237'

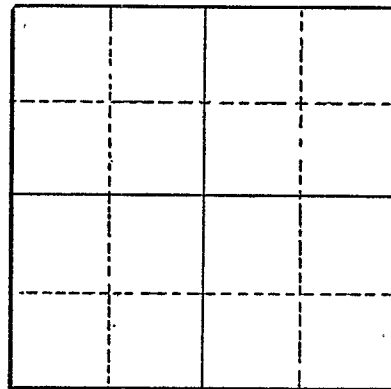

Section

Altitude at well

TYPE OF WELL: Drilled Date Constructed 1946

Depth drilled 45 Depth cased 40

CASING RECORD:

6-inch

FINISH:

AQUIFERS:

WATER LEVEL:

35-feet

PUMPING EQUIPMENT: Type Berkeley Jet H.P. 2
Capacity 100 G.P.M.

WELL TESTS:

Drawdown ft. after hours G.P.M.
Drawdown ft. after hours G.P.M.

USE OF WATER Irrigation Temp. °F. 19

SOURCE OF INFORMATION GR-2468

DRILLER or DIGGER Wayne Hayes, 535 Coburg Rd.

ADDITIONAL DATA:

Log Water Level Measurements Chemical Analysis Aquifer Test

REMARKS: