

STATE ENGINEER
Salem, Oregon

Well Record

LANE
16086

STATE WELL NO. 18/3W-1J
COUNTY Lane
APPLICATION NO. GR-3175

OWNER: Pacific Power & Light Co.


MAILING ADDRESS: Public Service Building

LOCATION OF WELL: Owner's No. Well #1

CITY AND STATE: Portland 4, Oregon

NE ¼ SE ¼ Sec. 1 T. 18 N. S., R. 3 E. W., W.M.

Bearing and distance from section or subdivision corner 2041.71 W. and 1698.61 S. of the SE Cor. of Isaac Briggs DLC #39

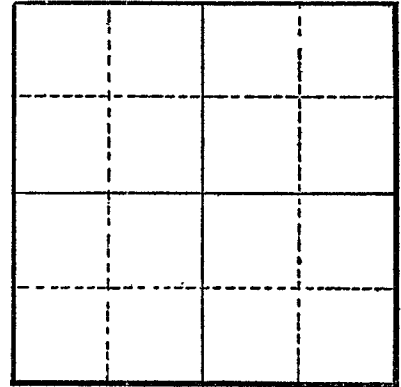

Section

Altitude at well

TYPE OF WELL: drilled Date Constructed 1951

Depth drilled 30' Depth cased 30'

CASING RECORD:

12"

FINISH:

5/8" x 16" slots spaced 2" on circumference from 15 to 30

AQUIFERS:

topsoil, gravel

WATER LEVEL:

PUMPING EQUIPMENT: Type Pomona Turbine 10" MC bowl "A" Impellers H.P. 60
Capacity 900 G.P.M.

WELL TESTS:

Drawdown	10	ft. after	hours	pumping	900	G.P.M.
Drawdown		ft. after	hours			G.P.M.

USE OF WATER Municipal supply Temp. °F. 19

SOURCE OF INFORMATION GR-3134

DRILLER or DIGGER Art Clinton Independence, Oregon

ADDITIONAL DATA:

Log Water Level Measurements Chemical Analysis Aquifer Test

REMARKS:

topsoil 0-7	7	7
water bearing gravel 7-30	23	30

Note; Well altered June, 1957 (See attached water well report dated April 3, 1958)