

STATE ENGINEER
Salem, Oregon


Well Record **LANE** STATE WELL NO. 18/3W-1
16091 COUNTY Lane
APPLICATION NO. GR-3177

OWNER: Pacific Power & Light Co. MAILING ADDRESS: Public Service Bldg.

LOCATION OF WELL: Owner's No. Well #4 CITY AND STATE: Portland 4, Oregon

NE 1/4 1/4 Sec. 1 T. 18 N. S., R. 3 E. W., W.M.

Bearing and distance from section or subdivision corner 2603.91 W. and 1751.97 S. from SE Cor. Isaac Briggs DIC #39

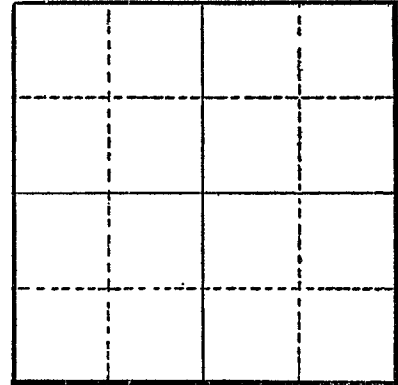

Section

Altitude at well

TYPE OF WELL: drilled Date Constructed 1951

Depth drilled 28' Depth cased 28'

CASING RECORD:

12"

FINISH:

5/8" x 16" slots spaced 2" on circumference from 13 to 28

AQUIFERS:

topsoil, gravel

WATER LEVEL:

12'

PUMPING EQUIPMENT: Type Pomona Turbine 12 MG-3AF3-X H.P. 75
Capacity 1100-1400 G.P.M.

WELL TESTS:

Drawdown 10 ft. after hours pumping 1250 G.P.M.
Drawdown ft. after hours G.P.M.

USE OF WATER Municipal Temp. °F., 19

SOURCE OF INFORMATION GR-3136

DRILLER or DIGGER Art Clinton, Independence, Oregon

ADDITIONAL DATA:

Log Water Level Measurements Chemical Analysis Aquifer Test

REMARKS:

Topsoil 0-7 7 7
water-bearing gravel 7-28 21 28

Note: Well altered June, 1957 (See attached water well report dated April 3, 1951)