

STATE ENGINEER
Salem, Oregon

Well Record

LANE
16093

STATE WELL NO. 18/3w-1J
COUNTY Lane
APPLICATION NO. GR-3181

OWNER: Pacific Power & Light Co.


MAILING ADDRESS: Public Service Bldg.

LOCATION OF WELL: Owner's No. Well #8

CITY AND STATE: Portland 4, Oregon

NE 1/4 SE 1/4 Sec. 1 T. 18 N. 3 E. S., R. 3 W., W.M.

Bearing and distance from section or subdivision
corner 1947.18 W. and 1882.52 S. from SE Cor.
Isaac Briggs DLC #39

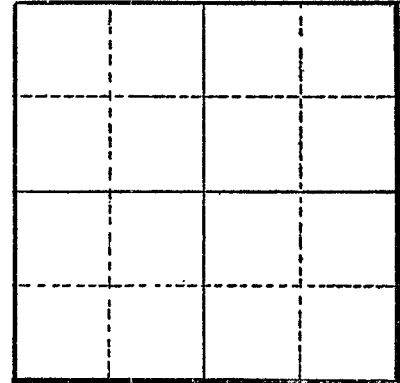

Section

Altitude at well

TYPE OF WELL: drilled Date Constructed 1951

Depth drilled 30' Depth cased 30'

CASING RECORD:

12"

FINISH:

5/8" x 16" Slots spaced 2" on circumference

AQUIFERS: topsoil, water bearing gravel

WATER LEVEL:

12'

PUMPING EQUIPMENT: Type Pomona Turbine H.P. 75
Capacity 1300 G.P.M.

WELL TESTS:

Drawdown 10 ft. after hours pumping 1250 G.P.M.

Drawdown ft. after hours G.P.M.

USE OF WATER Municipal Temp. °F. 19

SOURCE OF INFORMATION GR-3140

DRILLER or DIGGER Art Clinton, Independence, Oregon

ADDITIONAL DATA:

Log ☒ Water Level Measurements Chemical Analysis Aquifer Test

REMARKS:

topsoil 0-7 7 7
water bearing gravel 7-30 23 30