


OWNER: Pacific Power & Light Co. MAILING ADDRESS: Public Service Building

LOCATION OF WELL: Owner's No. Well #12 CITY AND STATE: Portland 4, Oregon

NW 1/4 SE 1/4 Sec. 1 T. 18 N. S. R. 3 E. W., W.M.

Bearing and distance from section or subdivision corner 3015.91 W. and 1657.61 S. from SE Cor. Isaac Briggs DLC #39

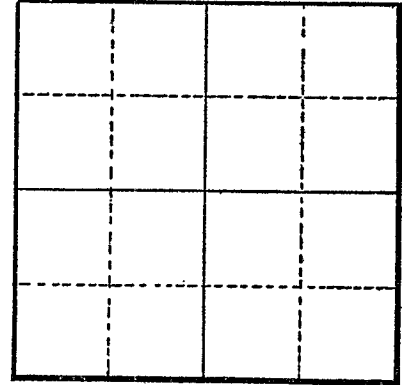

Section

Altitude at well

TYPE OF WELL: drilled Date Constructed 1953

Depth drilled 32' Depth cased 32'

CASING RECORD:

16"

FINISH:

5/8" x 16" slots spaced 2" on circumference from 12 to 32

AQUIFERS:

topsoil, water bearing gravel

WATER LEVEL:

12'

PUMPING EQUIPMENT: Type Pomona, Turbine, 12 MC-3AF3-X H.P. 75
Capacity 1200 G.P.M.

WELL TESTS:

Drawdown 10 ft. after hours pumping 1250 G.P.M.
Drawdown ft. after hours G.P.M.

USE OF WATER Municipal Temp. °F., 19

SOURCE OF INFORMATION GR-3138

DRILLER or DIGGER

ADDITIONAL DATA:

Log Water Level Measurements Chemical Analysis Aquifer Test

REMARKS:

topsoil 0-7 7 7
water bearing gravel 7-32 25 32

Note: Well altered 5/3/58 (See attached water well report dated 7/1/58)