


LANE
16/88

OWNER: C. O. Schrader MAILING ADDRESS: RR 4, Box 81

LOCATION OF WELL: Owner's No. CITY AND STATE: Eugene, Oregon

NW 1/4 SE 1/4 Sec. 11 T. 18 S., R. 3 W., W.M.

Bearing and distance from section or subdivision corner boundary line in SE Corner

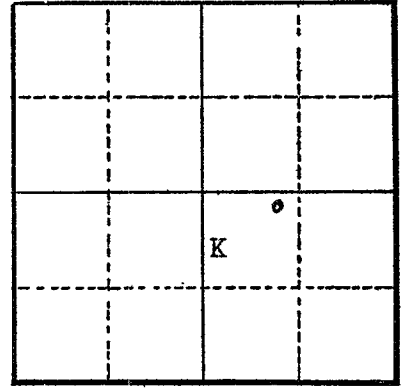

Altitude at well

TYPE OF WELL: Date Constructed June 1952

Depth drilled Depth cased

Section 11

CASING RECORD:

- A Sump - 7 foot Deep.

FINISH:

AQUIFERS:

WATER LEVEL:

PUMPING EQUIPMENT: Type Fairbanks Morse H.P.
Capacity 250 G.P.M.

WELL TESTS:
Drawdown ft. after hours G.P.M.
Drawdown ft. after hours G.P.M.

USE OF WATER Irrigation Temp. °F., 19

SOURCE OF INFORMATION GR-4141

DRILLER or DIGGER

ADDITIONAL DATA:
Log (NA) Water Level Measurements Chemical Analysis Aquifer Test

REMARKS: