

STATE ENGINEER
Salem, Oregon

Well Record

LANE
16189
STATE WELL NO. 18/3W-11K
COUNTY Lane
APPLICATION NO. GR-3397


OWNER: ^{C/O} C. O. Schrader MAILING ADDRESS: RR 4, Box 81

LOCATION OF WELL: Owner's No. CITY AND STATE: Eugene, Oregon

NW 1/4 SE 1/4 Sec. 11 T. 18 N. R. 3 E. W.M.

Bearing and distance from section or subdivision corner

800 ft South of NW corner of NW 1/4 SE 1/4 of Section 11

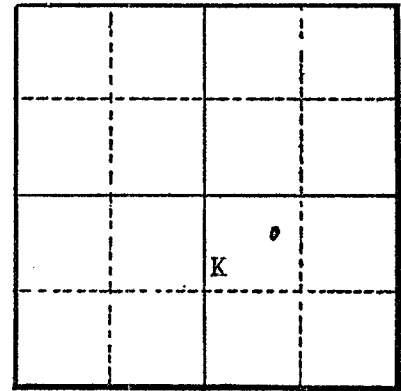

Section 11

Altitude at well

TYPE OF WELL: Date Constructed March-1952

Depth drilled Depth cased

CASING RECORD:

FINISH:

AQUIFERS:

WATER LEVEL:

PUMPING EQUIPMENT: Type Capacity G.P.M. H.P.

WELL TESTS: Drawdown ft. after hours G.P.M. Drawdown ft. after hours G.P.M.

USE OF WATER Industrial Temp. °F., 19

SOURCE OF INFORMATION GR-4140

DRILLER or DIGGER

ADDITIONAL DATA: Log (NA) Water Level Measurements Chemical Analysis Aquifer Test

REMARKS: