

STATE ENGINEER  
Salem, Oregon

Well Record **LANE** STATE WELL NO. 18/3W-11Q(1)  
16/9/ COUNTY Lane  
APPLICATION NO. GR-559

OWNER: Waldo & Josephine Hill


MAILING ADDRESS: Rt. 4, Box 108

LOCATION OF WELL: Owner's No. \_\_\_\_\_

CITY AND STATE: Eugene, Oregon

SW  $\frac{1}{4}$  SE  $\frac{1}{4}$  Sec. 11 T. 18 N. S., R. 3 E. W., W.M.

Bearing and distance from section or subdivision corner 980' E. & 513' N. of SW cor. SE  $\frac{1}{4}$  Sec.

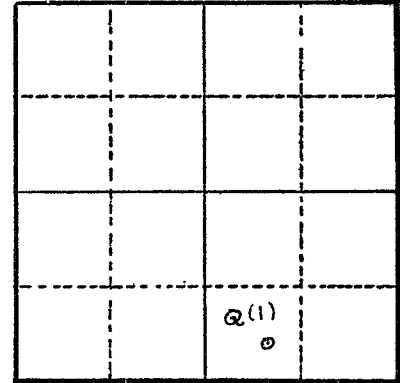

Section 11

Altitude at well 450 ft.

TYPE OF WELL: driven Date Constructed summer 1940

Depth drilled 18 ft. Depth cased 18 ft.

CASING RECORD: 3  $\frac{1}{2}$  inch

FINISH:

AQUIFERS:

WATER LEVEL: 8 ft.

PUMPING EQUIPMENT: Type Demming H.P. 9  $\frac{1}{2}$   
Capacity 200 G.P.M.

WELL TESTS:  
Drawdown 0 ft. after \_\_\_\_\_ hours 200 G.P.M.  
Drawdown \_\_\_\_\_ ft. after \_\_\_\_\_ hours \_\_\_\_\_ G.P.M.

USE OF WATER irrigation 5 acres Temp. \_\_\_\_\_ °F., 19 \_\_\_\_\_  
SOURCE OF INFORMATION GR-559

DRILLER or DIGGER \_\_\_\_\_

ADDITIONAL DATA:

Log \_\_\_\_\_ Water Level Measurements \_\_\_\_\_ Chemical Analysis \_\_\_\_\_ Aquifer Test \_\_\_\_\_

REMARKS: