


STATE ENGINEER
Salem, Oregon

Well Record **LANE** STATE WELL NO. 18/3W-12G
COUNTY Lane
GR- 1538 **16199** APPLICATION NO. GR- 1590

OWNER: Reese Wingard MAILING ADDRESS: 2510 Charnelton St.

LOCATION OF WELL: Owner's No. CITY AND STATE: Eugene, Oregon

NE 1/4 NW 1/4 Sec. 12 T. 18 S., R. 3 W., W.M.
Bearing and distance from section or subdivision
corner 1440' N. & 1638' E. from W 1/4 cor. Sec. 12

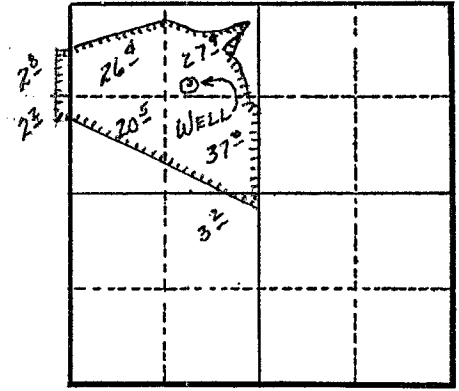

Altitude at well 470'

TYPE OF WELL: Driven Date Constructed 1953

Depth drilled 17' Depth cased 17'

Section 12

CASING RECORD:
4"

FINISH:

AQUIFERS:

WATER LEVEL:
8'

PUMPING EQUIPMENT: Type Pacific Cent. H.P. 15
Capacity 300 G.P.M.

WELL TESTS:
Drawdown 2 ft. after 300 hours G.P.M.
Drawdown ft. after hours G.P.M.

USE OF WATER Irrigation Temp. °F. 19

SOURCE OF INFORMATION GR Record

DRILLER or DIGGER

ADDITIONAL DATA:
Log Water Level Measurements Chemical Analysis Aquifer Test

REMARKS:
Log: Soil, river loam 0 to 6 ft.
Gravel 6 to 17 ft.

Irrigation of 120 acres.