

STATE ENGINEER  
Salem, Oregon

# Well Record <sup>LANE</sup>

ESTATE WELL NO. 18/3W-12A(1)

COUNTY Lane

APPLICATION NO. GR-1325

GR- 1280

16200

OWNER: Julio W. & Elizabeth N. Silva


MAILING ADDRESS: Box 5317

LOCATION OF WELL: Owner's No. #1

CITY AND STATE: Eugene, Oregon

NE 1/4 NE 1/4 Sec. 12 T. 18 S., R. 3 W., W.M.

Bearing and distance from section or subdivision corner S. 9° W. 720' from NE cor. Sec. 12.

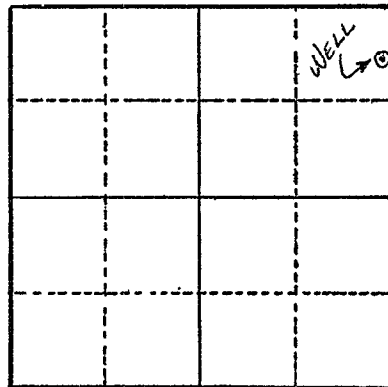

Section .....12.....

Altitude at well 450 ft.

TYPE OF WELL: Driven Date Constructed 1953

Depth drilled 20 ft. Depth cased 20 ft.

### CASING RECORD:

2 - 3 inch

### FINISH:

### AQUIFERS:

Sand & gravel

### WATER LEVEL:

9 ft.

PUMPING EQUIPMENT: Type 3 in. Cent. H.P. Gas engine  
Capacity 400 G.P.M.

### WELL TESTS:

Drawdown ..... ft. after ..... hours ..... G.P.M.  
Drawdown ..... ft. after ..... hours ..... G.P.M.

USE OF WATER Irrigation Temp. °F. , 19

SOURCE OF INFORMATION G. R. Record

DRILLER or DIGGER

### ADDITIONAL DATA:

Log N.A. Water Level Measurements Chemical Analysis Aquifer Test

### REMARKS:

Irrigation of 124.6 acres.