

STATE ENGINEER
Salem, Oregon

Well Record ^{LANE}
16201 STATE WELL NO. 18/3W-12A(2)
COUNTY Lane
APPLICATION NO. GR-1326

GR- 1281

OWNER: Julio W. & Elizabeth M. Silva


MAILING ADDRESS: Box 5317

LOCATION OF WELL: Owner's No. #2

CITY AND STATE: Eugene, Oregon

NE 1/4 NE 1/4 Sec. 12 T. 18 N. S., R. 3 E W., W.M.

Bearing and distance from section or subdivision corner S. 41°30'W. 1250' from NE cor. Sec. 12.

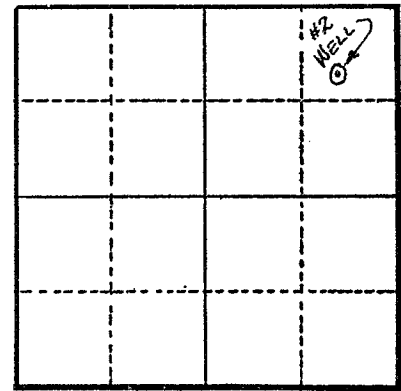

Section 12

Altitude at well 450 ft.

TYPE OF WELL: Driven Date Constructed 1953

Depth drilled 20 ft. Depth cased 20 ft.

CASING RECORD:

2 - 3 in.

FINISH:

AQUIFERS:

Sand & gravel

WATER LEVEL:

9 ft.

PUMPING EQUIPMENT: Type 3 in. Cent. H.P. 40

Capacity 400 G.P.M.

WELL TESTS:

Drawdown ft. after hours G.P.M.
Drawdown ft. after hours G.P.M.

USE OF WATER Irrigation Temp. °F., 19

SOURCE OF INFORMATION G. R. Record

DRILLER or DIGGER Ralph Compton

ADDITIONAL DATA:

Log N.A. Water Level Measurements Chemical Analysis Aquifer Test

REMARKS:

Irrigation of 124.6 acres.