

STATE ENGINEER
Salem, Oregon

Well Record

LANE
16202

STATE WELL NO. 18/3W-12B
COUNTY Lane
APPLICATION NO. GR-1327

GR- 1282

OWNER: Julio W. & Elizabeth M. Silva


MAILING ADDRESS: Box 5317

LOCATION OF WELL: Owner's No. #3

CITY AND STATE: Eugene, Oregon

N. E.
NW ¼ NE ¼ Sec. 12 T. 18 S., R. 3 W., W.M.

Bearing and distance from section or subdivision
corner S72°30'W. 1500' from NE cor. Sec. 12.

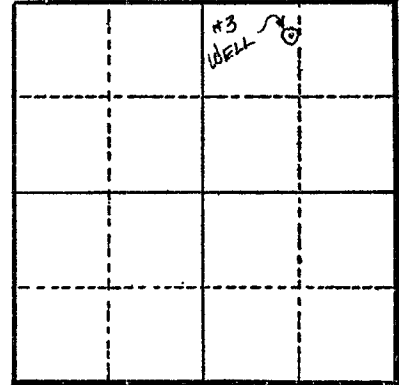

Section 12

Altitude at well

TYPE OF WELL: Driven Date Constructed 1953

Depth drilled 24 ft. Depth cased 24 ft.

CASING RECORD:

2 - 3 in.

FINISH:

AQUIFERS:

Sand & gravel

WATER LEVEL:

9 ft.

PUMPING EQUIPMENT: Type 3 in. Cent. H.P. Gas Engine
Capacity 400 G.P.M.

WELL TESTS:

Drawdown	ft. after	hours	G.P.M.
Drawdown	ft. after	hours	G.P.M.

USE OF WATER Irrigation Temp. °F. 19

SOURCE OF INFORMATION G. R. Record

DRILLER or DIGGER

ADDITIONAL DATA:

Log N.A. Water Level Measurements Chemical Analysis Aquifer Test

REMARKS:

Irrigation of 124.6 acres.