

STATE ENGINEER
Salem, Oregon

Well Record

LANE
16207

STATE WELL NO. 18/3W-12H
COUNTY Lane
APPLICATION NO. GR-3122

OWNER: John H. Seavey


MAILING ADDRESS: 2089 Potter

LOCATION OF WELL: Owner's No.

CITY AND STATE: Eugene, Oregon

SE 1/4 NE 1/4 Sec. 12 T. 18 N. S., R. 3 E. W., W.M.

Bearing and distance from section or subdivision corner 3.5 chs. N and 2.5 chs. W.

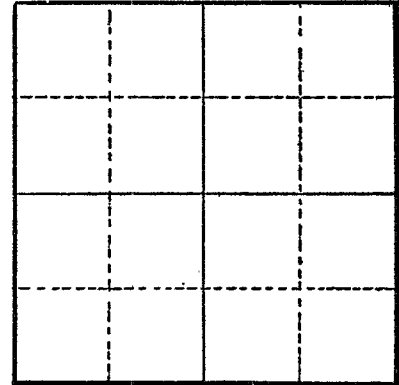

Section

Altitude at well

TYPE OF WELL: Dug Date Constructed 1945

Depth drilled 14' Depth cased

CASING RECORD:

FINISH:

AQUIFERS:

Soil, Sand, Rock

WATER LEVEL:

10'

PUMPING EQUIPMENT: Type Pacific centrifugal H.P. 5
Capacity 200 G.P.M.

WELL TESTS:

Drawdown ft. after hours G.P.M.
Drawdown ft. after hours G.P.M.

USE OF WATER Irrigation Temp. °F., 19

SOURCE OF INFORMATION GR-2929

DRILLER or DIGGER

ADDITIONAL DATA:

Log Water Level Measurements Chemical Analysis Aquifer Test

REMARKS:

Soil 9 9
Sand 1 10
Few Large rocks