

STATE ENGINEER
Salem, Oregon

Well Record **LANE**
16209

STATE WELL NO. 18/3W-12Q(1)
COUNTY Lane
APPLICATION NO. GR-721

OWNER: Wayne W. McBee


MAILING ADDRESS: Rt. 4, Box 119

LOCATION OF WELL: Owner's No. 1

CITY AND STATE: Eugene, Oregon

SW 1/4 SE 1/4 Sec. 12 T. 18 N. S., R. 3 W., W.M.

Bearing and distance from section or subdivision
corner 1287' E. & 720' N. of SW cor. SW 1/4 SE 1/4
Sec. 12

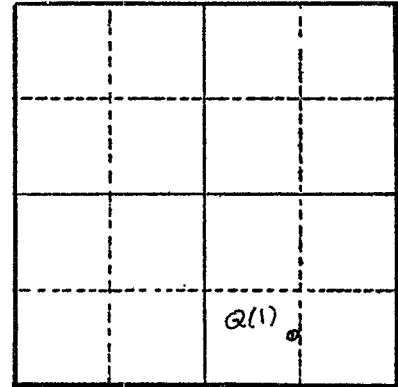

Section 12

Altitude at well 460 ft.

TYPE OF WELL: dug Date Constructed June 1930

Depth drilled 18 ft. Depth cased none

CASING RECORD: none

FINISH:

AQUIFERS:

WATER LEVEL: 12 ft.

PUMPING EQUIPMENT: Type Fairbanks Morse centrifugal 2 in. elec. H.P. 15
Capacity 300 G.P.M.

WELL TESTS:

Drawdown ft. after hours G.P.M.

Drawdown ft. after hours G.P.M.

USE OF WATER irrigation Temp. °F., 19

SOURCE OF INFORMATION GR-721

DRILLER or DIGGER

ADDITIONAL DATA:

Log Water Level Measurements Chemical Analysis Aquifer Test

REMARKS:

