

STATE ENGINEER
Salem, Oregon

Well Record

LANE
16210

STATE WELL NO. 18/3W-12Q(2)
COUNTY Lane
APPLICATION NO. GR-722

OWNER: Wayne W. McBee


MAILING ADDRESS: Rt. 4, Box 119

LOCATION OF WELL: Owner's No. 2

CITY AND STATE: Eugene, Oregon

SW 1/4 SE 1/4 Sec. 12 T. 18 N. S., R. 3 W., W.M.

Bearing and distance from section or subdivision
corner 520' E. & 617' N. of SW cor. SW 1/4 SE 1/4 Sec. 12

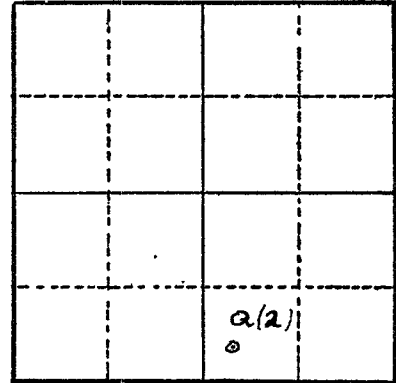

Section 12

Altitude at well 460 ft.

TYPE OF WELL: dug Date Constructed June 1938

Depth drilled 17 ft. Depth cased 17 ft.

CASING RECORD: none

FINISH:

AQUIFERS:

WATER LEVEL: 12 ft.

PUMPING EQUIPMENT: Type Ford Mod. A gas Deming centrifugal 1 1/2" H.P. 15
Capacity 200 G.P.M.

WELL TESTS:

Drawdown ft. after hours G.P.M.
Drawdown ft. after hours G.P.M.

USE OF WATER irrigation Temp. °F., 19

SOURCE OF INFORMATION GR-722

DRILLER or DIGGER

ADDITIONAL DATA:

Log Water Level Measurements Chemical Analysis Aquifer Test

REMARKS:

