

STATE ENGINEER
Salem, Oregon


Well Record **LANE** STATE WELL NO. 18/3W-12R
16214 COUNTY Lane
GR- 1430 APPLICATION NO. GR- 1313

OWNER: Harald Estep MAILING ADDRESS: Rt. 4, Box 120

LOCATION OF WELL: Owner's No. CITY AND STATE: Eugene, Oregon

SE 1/4 SE 1/4 Sec. 12 T. 18 N. S., R. 3 EX W., W.M.

Bearing and distance from section or subdivision corner 300' N. & 590' W. from SE cor. Sec. 12.

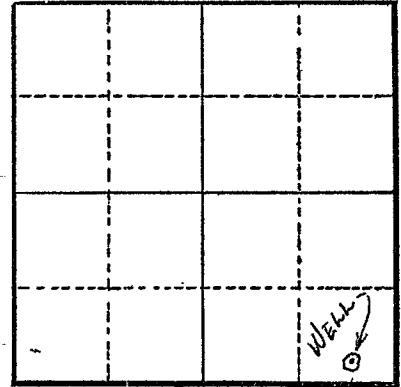

Section 12

Altitude at well

TYPE OF WELL: Driven Date Constructed 1950

Depth drilled 20' Depth cased 20'

CASING RECORD:
3"

FINISH:

AQUIFERS:

WATER LEVEL:
7'

PUMPING EQUIPMENT: Type Montgomery Ward 1 1/2" Cent. H.P. 2
Capacity 50 G.P.M.

WELL TESTS:
Drawdown 8 ft. after _____ hours 50 G.P.M.
Drawdown _____ ft. after _____ hours _____ G.P.M.

USE OF WATER Irrigation Temp. _____ °F., 19

SOURCE OF INFORMATION GR Record

DRILLER or DIGGER

ADDITIONAL DATA:

Log N.A. Water Level Measurements _____ Chemical Analysis _____ Aquifer Test _____

REMARKS:

Irrigation of 3 acres.