

STATE ENGINEER
Salem, Oregon

Well Record **LANE** STATE WELL NO. 18/3W-13A
16271 COUNTY Lane
APPLICATION NO. GR-836

OWNER: John C. Johnson


MAILING ADDRESS: Rt. 4, Box 118

LOCATION OF WELL: Owner's No. 1

CITY AND STATE: Eugene, Oregon

NE 1/4 NE 1/4 Sec. 13 T. 18 N. S., R. 3 E. W., W.M.

Bearing and distance from section or subdivision
corner 700' W. & 1000' S. of NE cor. Sec. 13

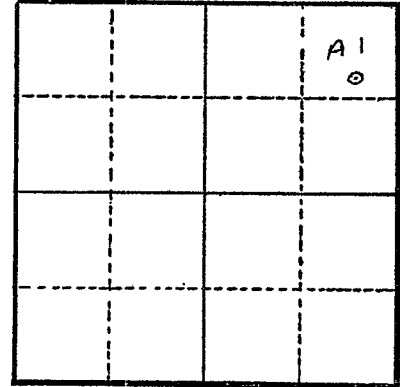

Section 13

Altitude at well

TYPE OF WELL: trench Date Constructed 1952

Depth drilled 9 ft. Depth cased

CASING RECORD:

FINISH: In-fil. trench. 200 ft. x 14 ft. 3 ft. min. depth 9 ft. max.
Open trench

AQUIFERS:

WATER LEVEL:

PUMPING EQUIPMENT: Type centrifugal Fairbanks Morse H.P. 15 elec.
Capacity 300 G.P.M.

WELL TESTS:

Drawdown ft. after hours G.P.M.

Drawdown ft. after hours G.P.M.

USE OF WATER Irrigation Temp. °F., 19

SOURCE OF INFORMATION owner

DRILLER or DIGGER

ADDITIONAL DATA:

Log Water Level Measurements Chemical Analysis Aquifer Test

REMARKS: