

STATE ENGINEER
Salem, Oregon

Well Record

LANE
16272

STATE WELL NO. 18/3W-13A(2)
COUNTY Lane
APPLICATION NO. GR-832

OWNER: John C. Johnson


MAILING ADDRESS: Rt. 4, Box 118

LOCATION OF WELL: Owner's No. 2

CITY AND STATE: Eugene, Oregon

NE 1/4 NE 1/4 Sec. 13 T. 18 N. S., R. 3 E. W.M.

Bearing and distance from section or subdivision
corner 800' W. & 300' S. from cor. Sec. 13

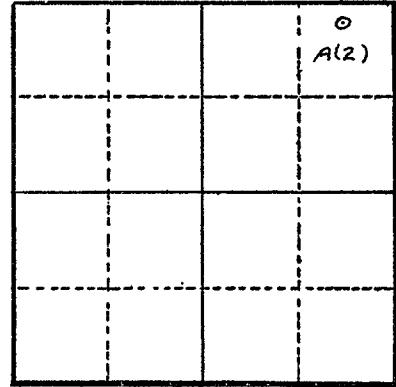

Section 13

Altitude at well

TYPE OF WELL: trench Date Constructed 1945

Depth drilled Depth cased

CASING RECORD:

FINISH: In filtration trench 20 ft. x 16 ft. 10 ft. depth
open trench.

AQUIFERS:

WATER LEVEL:

PUMPING EQUIPMENT: Type Fairbanks Morse H.P. 10 elec.
Capacity 200 G.P.M.

WELL TESTS:

Drawdown ft. after hours G.P.M.
Drawdown ft. after hours G.P.M.

USE OF WATER irrigation Temp. °F., 19

SOURCE OF INFORMATION owner

DRILLER or DIGGER

ADDITIONAL DATA:

Log Water Level Measurements Chemical Analysis Aquifer Test

REMARKS: