

STATE ENGINEER
Salem, Oregon

Well Record **LANE** STATE WELL NO. 18/3W-13B(1)
16294 COUNTY Lane
APPLICATION NO. GR-838

OWNER: John C. Johnson


MAILING ADDRESS: Rt. 4, Box 118

LOCATION OF WELL: Owner's No.

CITY AND STATE: Eugene, Oregon

NW 1/4 NE 1/4 Sec. 13 T. 18 N. S., R. 3 E. W., W.M.

Bearing and distance from section or subdivision
corner 600' S. & 200' E. from N 1/4 cor. Sec. 13

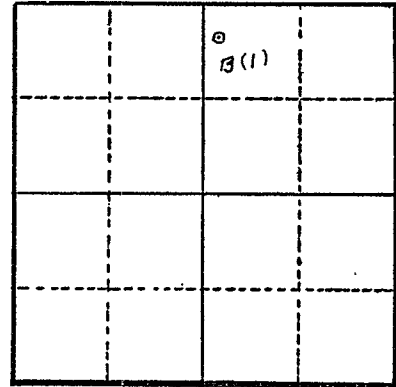

Section 13

Altitude at well

TYPE OF WELL: trench & dug Date Constructed 1952

Depth drilled 4 ft. max. Depth cased

CASING RECORD:

FINISH: Infiltration trench 100 ft. x 12 ft. Max. depth 4 ft.

AQUIFERS:

WATER LEVEL:

PUMPING EQUIPMENT: Type centrifugal Montgomer Ward H.P. 1/2 gas
Capacity 60 G.P.M.

WELL TESTS:

Drawdown ft. after hours G.P.M.

Drawdown ft. after hours G.P.M.

USE OF WATER irrigation Temp. °F., 19

SOURCE OF INFORMATION owner

DRILLER or DIGGER

ADDITIONAL DATA:

Log Water Level Measurements Chemical Analysis Aquifer Test

REMARKS: