

STATE ENGINEER
Salem, Oregon

Well Record

STATE WELL NO. 18/3W-13B(2)
COUNTY Lane
APPLICATION NO. GR-839

16215

OWNER: J. C. Johnson


MAILING ADDRESS: _____

LOCATION OF WELL: Owner's No. _____

CITY AND STATE: _____

NW 1/4 NE 1/4 Sec. 13 T. 18 N. S. R. 3 E. W., W.M.

Bearing and distance from section or subdivision corner _____

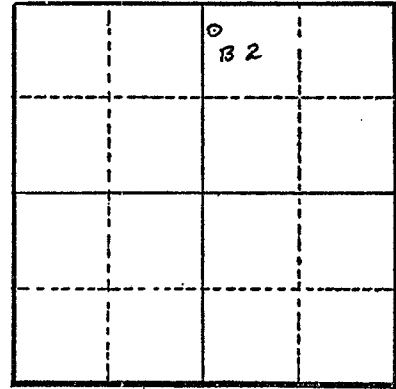

Section 13

Altitude at well _____

TYPE OF WELL: driven Date Constructed 1954

Depth drilled 20 Depth cased _____

CASING RECORD: 2 inch

FINISH: none

AQUIFERS: _____

WATER LEVEL: 8 ft.

PUMPING EQUIPMENT: Type centrifugal 2 inch H.P. 4
Capacity 45 G.P.M.

WELL TESTS:
Drawdown 10 ft. after _____ hours 50 G.P.M.
Drawdown _____ ft. after _____ hours _____ G.P.M.

USE OF WATER irrigation Temp. _____ °F. _____, 19

SOURCE OF INFORMATION GR-839

DRILLER or DIGGER _____

ADDITIONAL DATA:
Log _____ Water Level Measurements _____ Chemical Analysis _____ Aquifer Test _____

REMARKS: _____