

STATE ENGINEER
Salem, Oregon


Well Record **LANE** STATE WELL NO. 18/3W-13D
16280 COUNTY Lane
APPLICATION NO. GR-3565

OWNER: Victor E. Hansen MAILING ADDRESS: Route 4 Box 116

LOCATION OF WELL: Owner's No. CITY AND STATE: Eugene, Oregon

N. E.
NW 1/4 NW 1/4 Sec. 13 T. 18 S., R. 3 W., W.M.

Bearing and distance from section or subdivision corner 926.2 ft. E. of Sec. 14 and 377.7 ft. S. of Sec. 13

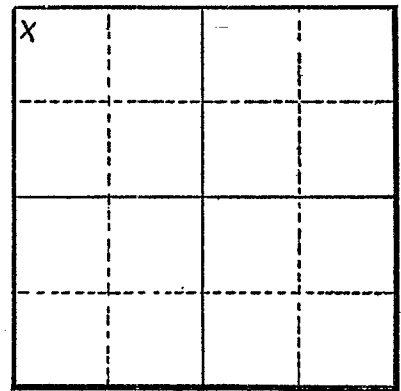

Section 13

Altitude at well

TYPE OF WELL: dug Date Constructed 1953

Depth drilled 16 ft. Depth cased

CASING RECORD:

FINISH:

AQUIFERS:

WATER LEVEL:
10 feet below surface

PUMPING EQUIPMENT: Type Fairbanks Morse Hi power H.P. 5
Capacity 140 G.P.M.

WELL TESTS:
Drawdown 1.6 ft. after hours 240 G.P.M.
Drawdown ft. after hours G.P.M.

USE OF WATER Irrigation Temp. °F. 19

SOURCE OF INFORMATION Well Registration Statement

DRILLER or DIGGER

ADDITIONAL DATA:
Log Water Level Measurements Chemical Analysis Aquifer Test

REMARKS: