

STATE ENGINEER
Salem, Oregon

Well Record ~~LANE~~ STATE WELL NO. 18/3W-13H(1)
16282 COUNTY Lane
APPLICATION NO. GR-745

OWNER: Floyd McBee


MAILING ADDRESS: Rt. 4, Box 138

LOCATION OF WELL: Owner's No.

CITY AND STATE: Eugene, Oregon

SE 1/4 NE 1/4 Sec. 13 T. 18 N. S., R. 3 E. W., W.M.

Bearing and distance from section or subdivision
corner 1720' N. & 1550' E. of SE cor. Washington
L. Riggs DLC

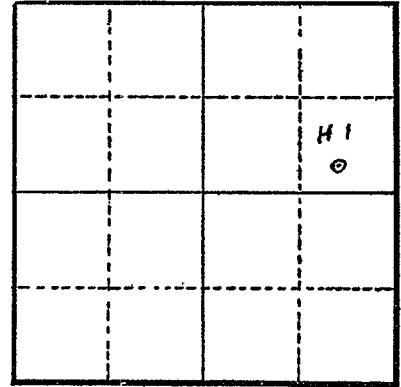

Section 13

Altitude at well 395 ft. Interpolated

TYPE OF WELL: driven Date Constructed 5/15/46

Depth drilled 21 ft. Depth cased 21 ft.

CASING RECORD: 4 in. from surface to 21 ft.

FINISH:

AQUIFERS:

WATER LEVEL: 7 feet

PUMPING EQUIPMENT: Type Single phase elec. Berkeley cent. 1 1/2 in. H.P. 3
Capacity 60 G.P.M.

WELL TESTS:

Drawdown ft. after hours G.P.M.

Drawdown ft. after hours G.P.M.

USE OF WATER irrigation Temp. °F. , 19

SOURCE OF INFORMATION GR-745

DRILLER or DIGGER owner

ADDITIONAL DATA:

Log Water Level Measurements Chemical Analysis Aquifer Test

REMARKS: