

STATE ENGINEER  
Salem, Oregon

Well Record LANE STATE WELL NO. 18/3W-13J  
COUNTY LANE  
APPLICATION NO. GR-2817

OWNER: James K. Holsinger


MAILING ADDRESS: Rt. 4, Box 130

LOCATION OF WELL: Owner's No. \_\_\_\_\_

CITY AND STATE: Eugene, Oregon

NE 1/4 SE 1/4 Sec. 13 T. 18 N. S, R. 3 E. W., W.M.

Bearing and distance from section or subdivision corner 1550' N. and 300' W.

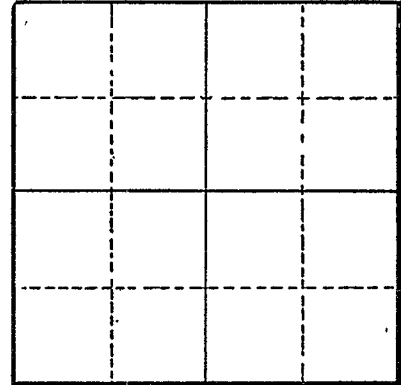

Section \_\_\_\_\_

Altitude at well \_\_\_\_\_

TYPE OF WELL: driven Date Constructed 1948

Depth drilled 18 Depth cased \_\_\_\_\_

CASING RECORD:

2-inch

FINISH:

5/6" perforated 3' perforated pipe at bottom

AQUIFERS:

Sand and gravel

WATER LEVEL:

8-feet

PUMPING EQUIPMENT: Type Deming H.P. 5  
Capacity \_\_\_\_\_ G.P.M.

WELL TESTS:

Drawdown \_\_\_\_\_ ft. after \_\_\_\_\_ hours \_\_\_\_\_ G.P.M.  
Drawdown \_\_\_\_\_ ft. after \_\_\_\_\_ hours \_\_\_\_\_ G.P.M.

USE OF WATER irrigation Temp. \_\_\_\_\_ °F. \_\_\_\_\_, 19\_\_\_\_\_

SOURCE OF INFORMATION GR-2658

DRILLER or DIGGER \_\_\_\_\_

ADDITIONAL DATA:

Log  Water Level Measurements \_\_\_\_\_ Chemical Analysis \_\_\_\_\_ Aquifer Test \_\_\_\_\_

REMARKS:

8' sand then strike gravel