

STATE ENGINEER  
Salem, Oregon


Well Record **LANE** STATE WELL NO. 18/3W-13K  
116284 COUNTY Lane  
APPLICATION NO. GR-4035

OWNER: Charles M. Fuhrer & Hazel L. Fuhrer MAILING ADDRESS: Route 4, Box 142-T

LOCATION OF WELL: Owner's No. \_\_\_\_\_ CITY AND STATE: Eugene, Oregon

NW 1/4 SE 1/4 Sec. 13 T. 18 S., R. 3 W., W.M.

Bearing and distance from section or subdivision  
corner Beginning at Washington L. Riggs, sly.  
SE Cor. DLC #40 N. 150' Thence E. 65 ft.  
to well

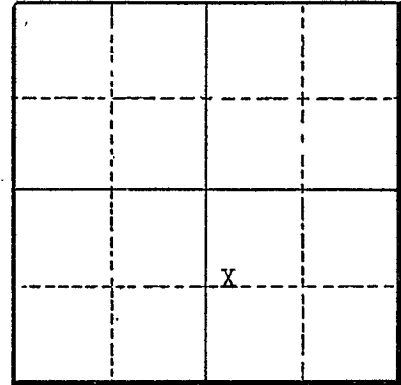

Section 13

Altitude at well \_\_\_\_\_

TYPE OF WELL: Drilled Date Constructed 10/52

Depth drilled 46 ft. Depth cased 21 ft.

CASING RECORD:

5 inch casing set to 21 feet

FINISH:

AQUIFERS:

WATER LEVEL:

12 feet below surface

PUMPING EQUIPMENT: Type Berkeley pump H.P. 1  
Capacity 15 G.P.M.

WELL TESTS:

Drawdown 10 ft. after \_\_\_\_\_ hours 500 G.P.M.  
Drawdown \_\_\_\_\_ ft. after \_\_\_\_\_ hours \_\_\_\_\_ G.P.M.

USE OF WATER Irrigation Temp. \_\_\_\_\_ °F., 19 \_\_\_\_\_

SOURCE OF INFORMATION Well Registration Statement Cert. # GR-3638

DRILLER or DIGGER Curtis Miller

ADDITIONAL DATA:

Log X Water Level Measurements \_\_\_\_\_ Chemical Analysis \_\_\_\_\_ Aquifer Test \_\_\_\_\_

REMARKS: Log Thickness Depth to Bottom  
Blue clay 19 19  
Hard blue and black shale 27 27  
Gravel and sand at source of water. At break through  
of shale, the source of the water supply.