

STATE ENGINEER
Salem, Oregon


Well Record **LANE**
16329
STATE WELL NO. 18/3W-16M
COUNTY Lane
APPLICATION NO. GR-3938

OWNER: John R. Seeley
MAILING ADDRESS: 373 Skyline Park Loop

LOCATION OF WELL: Owner's No. _____
CITY AND STATE: Eugene, Oregon

NW 1/4 SW 1/4 Sec. 16 T. 18 S., R. 3 W., W.M.

Bearing and distance from section or subdivision
corner 860' S. & 520' E. from W 1/4 Cor. Sec. 16

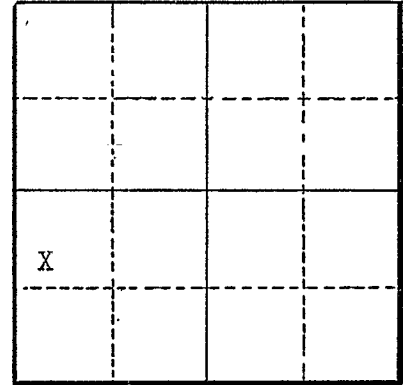

Section 16

Altitude at well _____

TYPE OF WELL: Drilled Date Constructed 1953

Depth drilled 100 ft. Depth cased 36 ft.

CASING RECORD:

4 inch well casing set to 36 feet

FINISH:

AQUIFERS:

WATER LEVEL:

36 feet below surface

PUMPING EQUIPMENT: Type jet H.P. 1
Capacity 20 G.P.M.

WELL TESTS:

Drawdown _____ ft. after _____ hours _____ G.P.M.
Drawdown _____ ft. after _____ hours _____ G.P.M.

USE OF WATER Irrigation Temp. _____ °F., 19

SOURCE OF INFORMATION Well Registration Statement Cert. # GR-3662

DRILLER or DIGGER Curtis Miller

ADDITIONAL DATA:

Log _____ Water Level Measurements _____ Chemical Analysis _____ Aquifer Test _____

REMARKS: