

STATE ENGINEER
Salem, Oregon

Well Record **LANE** STATE WELL NO. **18/3W-16M**
16332 COUNTY **Lane**
APPLICATION NO. **GR-1560**

OWNER: Skyline Park Mutual Water Co.
% Wm. M. Sloan, Sec. - Tres.

MAILING

ADDRESS: 223 Barber Drive

LOCATION OF WELL: Owner's No.


CITY AND

STATE: Eugene, Oregon

NW 1/4 SW 1/4 Sec. 16 T. 18 S., R. 3 W., W.M.

Bearing and distance from section or subdivision

corner 704' S. & 737' E. from W 1/4 Cor. Sec. 16

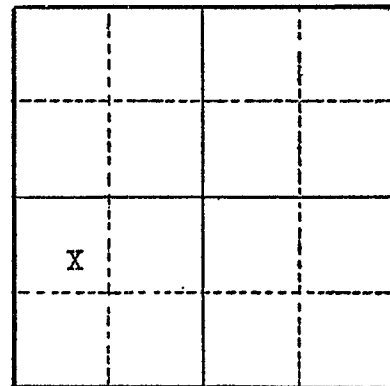

Section 16

Altitude at well

TYPE OF WELL: Drilled Date Constructed 9/53

Depth drilled 90 ft. Depth cased 34.5 ft.

CASING RECORD:

6 inch casing set to 34.5 feet

FINISH:

AQUIFERS:

WATER LEVEL:

29.5 feet below surface

PUMPING EQUIPMENT: Type Fairbanks Morse deep well jet H.P. 2
Capacity 16 G.P.M.

WELL TESTS:

Drawdown 8 ft. after hours 15 G.P.M.

Drawdown ft. after hours G.P.M.

USE OF WATER Domestic Temp. °F., 19

SOURCE OF INFORMATION Well Registration Statement Cert. # GR-3789

DRILLER or DIGGER Curtis E. Miller

ADDITIONAL DATA:

Log X Water Level Measurements Chemical Analysis Aquifer Test

REMARKS:

Log:

Plain shale water bearing 4.5 feet
Blue rock water bearing

Thickness Depth to Bottom
34 34
56 90