

STATE ENGINEER  
Salem, Oregon

Well Record **LANE** STATE WELL NO. 18/3W-18G  
**16344** COUNTY LANE  
~~APPLICATION NO. GR-2501~~

OWNER: Eugene Memorial Gardens, Inc.

MAILING ADDRESS:


LOCATION OF WELL: Owner's No. #1

CITY AND STATE: Eugene, Oregon

SW 1/4 NE 1/4 Sec. 18 T. 18 S., R. 3 W., W.M.

Bearing and distance from section or subdivision

corner 1500' S. & 1490' W.

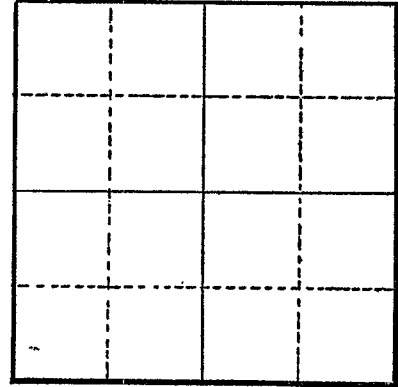

Section

Altitude at well

TYPE OF WELL: Drilled Date Constructed 1953

Depth drilled 390 Depth cased

CASING RECORD:

8-inch

FINISH:

AQUIFERS:

WATER LEVEL:

80 - 100-feet

PUMPING EQUIPMENT: Type Fairbanks Morse Turbine H.P. 5  
Capacity 30 G.P.M.

WELL TESTS:

Drawdown 50 ft. after hours Pumping 20 G.P.M.

Drawdown ft. after hours G.P.M.

USE OF WATER Irrigation Temp. °F. 19

SOURCE OF INFORMATION GR-2368

DRILLER or DIGGER Casey Jones, Eugene, Oregon

ADDITIONAL DATA:

Log Water Level Measurements Chemical Analysis Aquifer Test

REMARKS: