

STATE ENGINEER
Salem, Oregon

Well Record

STATE WELL NO. 18/3W-18G
COUNTY LANE
APPLICATION NO. GR-2502

16345

OWNER: Eugene Memorial Gardens, Inc.

MAILING ADDRESS:


LOCATION OF WELL: Owner's No.

CITY AND STATE:

Eugene, Oregon

SW 1/4 NE 1/4 Sec. 18 T. 18 S., R. 3 W., W.M.

Bearing and distance from section or subdivision corner 1390' S. and 2080' W.

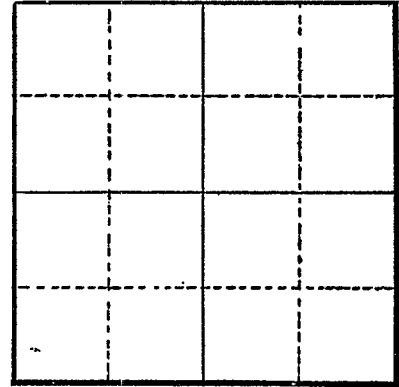

Section

Altitude at well

TYPE OF WELL: Drilled Date Constructed 1954

Depth drilled 100 Depth cased

CASING RECORD:

8-inch

FINISH:

AQUIFERS:

WATER LEVEL:

80 - 100-feet

PUMPING EQUIPMENT: Type Jet

H.P. 3

Capacity 25 G.P.M.

WELL TESTS:

Drawdown Total ft. after hours Pumping 17 G.P.M.

Drawdown ft. after hours G.P.M.

USE OF WATER Irrigation Temp. °F., 19

SOURCE OF INFORMATION GR-2369

DRILLER or DIGGER Casey Jones, Eugene, Oregon

ADDITIONAL DATA:

Log Water Level Measurements Chemical Analysis Aquifer Test

REMARKS: