

STATE ENGINEER  
Salem, Oregon

*Lane*  
16440

Well Record **LANE** STATE WELL NO. 18/3W-23B


COUNTY Lane  
APPLICATION NO. GR-4165

OWNER: Bonneville Power Administration MAILING ADDRESS: P.O. Box 3537

LOCATION OF WELL: Owner's No. \_\_\_\_\_ CITY AND STATE: Portland 8, Oregon

NW ¼ NE ¼ Sec. 23 T. 18 S., R. 3 W., W.M.

Bearing and distance from section or subdivision corner 290' E. & 14' S. of NW Cor. of NE¼

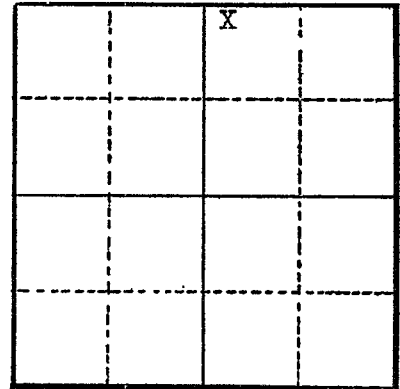

Section 23

Altitude at well \_\_\_\_\_

TYPE OF WELL: Drilled Date Constructed 12/50

Depth drilled 183 ft. Depth cased 81 ft.

CASING RECORD:

10 in. standard pipe from surface to 81 feet

FINISH:

AQUIFERS:

WATER LEVEL:

1 foot below surface

PUMPING EQUIPMENT: Type Jacuzzi LC8A 8 stage H.P. 7½  
Capacity 135 G.P.M.

WELL TESTS:

Drawdown 45 ft. after \_\_\_\_\_ hours 150 G.P.M.  
Drawdown 35 ft. after \_\_\_\_\_ hours 135 G.P.M.

USE OF WATER Domestic & Industrial Temp. \_\_\_\_\_ °F. \_\_\_\_\_, 19

SOURCE OF INFORMATION Well Registration Statement Cert. # GR-3730

DRILLER or DIGGER R. J. Strasser

ADDITIONAL DATA:

Log  Water Level Measurements \_\_\_\_\_ Chemical Analysis \_\_\_\_\_ Aquifer Test \_\_\_\_\_

REMARKS:

