


STATE ENGINEER
Salem, Oregon

Well Record ^{LANE} STATE WELL NO. 18/3W-23B
10442 COUNTY Lane
APPLICATION NO. GR-4078

OWNER: E. E. Cone (Cone Lumber Co.) MAILING ADDRESS: _____

LOCATION OF WELL: Owner's No. _____ CITY AND STATE: Goshen, Oregon

NW 1/4 NE 1/4 Sec. 23 T. 18 N. S., R. 3 W., W.M.
Bearing and distance from section or subdivision
corner 1000' S. & 1390' W. from NE Cor. Sec. 23

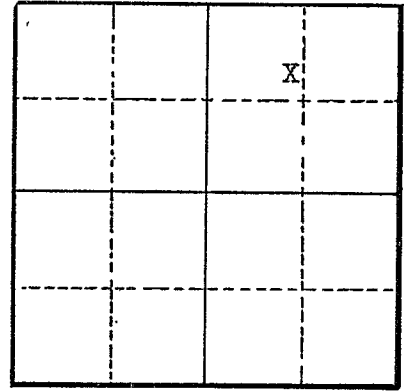

Section 23

Altitude at well _____

TYPE OF WELL: Drilled Date Constructed 8/48
Depth drilled 20 ft. Depth cased 20 ft.

CASING RECORD:

5 inch casing set to 20 ft.

FINISH:

AQUIFERS:

WATER LEVEL:

PUMPING EQUIPMENT: Type Berkeley H.P. 1
Capacity 25 G.P.M.

WELL TESTS:

Drawdown _____ ft. after _____ hours _____ G.P.M.
Drawdown _____ ft. after _____ hours _____ G.P.M.

USE OF WATER Industrial Temp. _____ °F. _____ 19
SOURCE OF INFORMATION Well Registration Statement Cert. # GR-3674

DRILLER or DIGGER
ADDITIONAL DATA:

Log _____ Water Level Measurements _____ Chemical Analysis _____ Aquifer Test _____

REMARKS: