


STATE ENGINEER  
Salem, Oregon

Well Record LANE STATE WELL NO. 18/3W-23G  
16443 COUNTY Lane  
APPLICATION NO. GR-4079

OWNER: E. E. Cone (Cone Lumber Co.) MAILING ADDRESS: \_\_\_\_\_  
CITY AND STATE: Goshen, Oregon

LOCATION OF WELL: Owner's No. \_\_\_\_\_  
SW 1/4 NE 1/4 Sec. 23 T. 18 N. S., R. 3 W., W.M.  
Bearing and distance from section or subdivision  
corner 1670' W. & 1480' S from NE Cor. Sec. 23

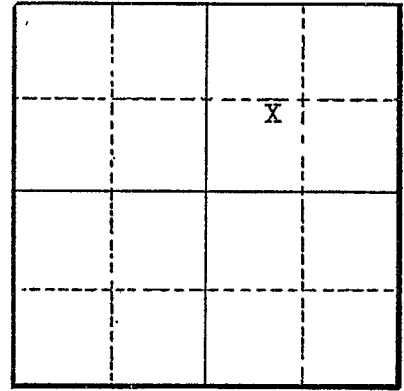

Section 23

Altitude at well \_\_\_\_\_

TYPE OF WELL: Drilled Date Constructed Aug., 1948  
Depth drilled \_\_\_\_\_ Depth cased 20 ft.

CASING RECORD:

5 inch casing set to 20 feet

FINISH:

AQUIFERS:

WATER LEVEL:

PUMPING EQUIPMENT: Type submersible H.P. 1  
Capacity 25 G.P.M.

WELL TESTS:

Drawdown \_\_\_\_\_ ft. after \_\_\_\_\_ hours \_\_\_\_\_ G.P.M.  
Drawdown \_\_\_\_\_ ft. after \_\_\_\_\_ hours \_\_\_\_\_ G.P.M.

USE OF WATER Industrial Temp. \_\_\_\_\_ °F., 19 \_\_\_\_\_  
SOURCE OF INFORMATION Well Registration Statement Cert. # GR-3675

DRILLER or DIGGER \_\_\_\_\_

ADDITIONAL DATA:

Log \_\_\_\_\_ Water Level Measurements \_\_\_\_\_ Chemical Analysis \_\_\_\_\_ Aquifer Test \_\_\_\_\_

REMARKS: