

STATE ENGINEER
Salem, Oregon

Well Record

STATE WELL NO. 18/3W-23G

COUNTY Lane

APPLICATION NO. GR-4077

OWNER: E. E. Gone (Gone Lumber Co.)


MAILING ADDRESS: _____

LOCATION OF WELL: Owner's No. _____

CITY AND STATE: Goshen, Oregon

SW ¼ NE ¼ Sec. 23 T. 18 S., R. 3 W., W.M.

Bearing and distance from section or subdivision corner 1350' S. & 1500' W. from NE Cor. Sec. 23

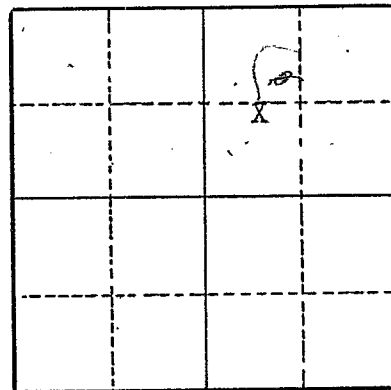

Section 23

Altitude at well _____

TYPE OF WELL: Drilled. Date Constructed 8/48

Depth drilled _____ Depth cased 20 ft.

CASING RECORD:

5 inch casing set to 20 feet

FINISH:

AQUIFERS:

WATER LEVEL:

PUMPING EQUIPMENT: Type Reda submersible H.P. 2
Capacity 40 G.P.M.

WELL TESTS:
Drawdown _____ ft. after _____ hours _____ G.P.M.
Drawdown _____ ft. after _____ hours _____ G.P.M.

USE OF WATER Industrial Temp. _____ °F., 19
SOURCE OF INFORMATION Well Registration Statement Cert. # GR-3673

DRILLER or DIGGER _____

ADDITIONAL DATA:
Log _____ Water Level Measurements _____ Chemical Analysis _____ Aquifer Test _____

REMARKS: