


STATE ENGINEER
Salem, Oregon

Well Record ^{LANE}

STATE WELL NO. 18/3W-26D
COUNTY Lane
APPLICATION NO. GR-3630

OWNER: Earl G. Jones
MAILING ADDRESS: Route 4, Box 210 D
CITY AND STATE: Eugene, Oregon

LOCATION OF WELL: Owner's No. _____
Well #1
NW 1/4 NW 1/4 Sec. 26 T. 18 S. R. 3 W., W.M.
Bearing and distance from section or subdivision
corner 1300 feet E. & 410 feet S. from NW cor.
Sec. 26

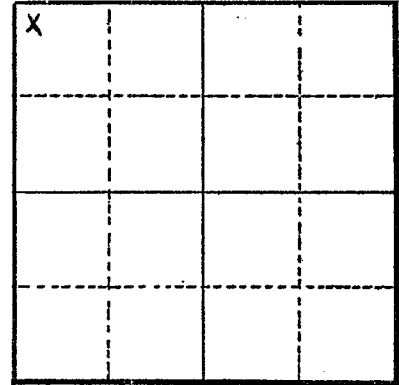

Section 26

Altitude at well _____

TYPE OF WELL: Drilled Date Constructed July, 1955
Depth drilled 65 feet Depth cased 30 feet

CASING RECORD:

6 inch black iron "coated" casing set from 0 to 30 feet

FINISH:

AQUIFERS:

WATER LEVEL:

PUMPING EQUIPMENT: Type Montgomery Ward jet H.P. 3/4
Capacity 25 G.P.M.

WELL TESTS:

Drawdown 25 ft. after 40 hours G.P.M.
Drawdown _____ ft. after _____ hours G.P.M.

USE OF WATER Irrigation Temp. _____ °F., 19

SOURCE OF INFORMATION Well Registration Statement

DRILLER or DIGGER Casey Jones Well Drilling

ADDITIONAL DATA:

Log Water Level Measurements _____ Chemical Analysis _____ Aquifer Test _____

REMARKS:

Log;
top soil Thickness 2 Depth to Bottom
clay 26 28
shale type rock - water bearing to 65 feet unknown