

STATE ENGINEER
Salem, Oregon

Well Record **LANE** STATE WELL NO. 18/4W-2J
16745 COUNTY LANE
APPLICATION NO. GR-2608

OWNER: E. D. Furrer


MAILING ADDRESS: 2432 City View Rd.

LOCATION OF WELL: Owner's No.

CITY AND STATE: Eugene, Oregon

NE 1/4 SE 1/4 Sec. 2 T. 18 N. S., R. 4 W., W.M.

Bearing and distance from section or subdivision corner 586' S. & 60' W.

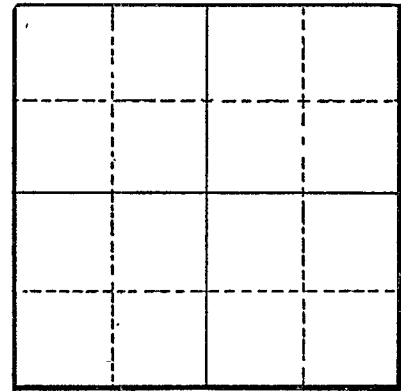

Section

Altitude at well

TYPE OF WELL: Drilled Date Constructed 1938

Depth drilled 68 Depth cased 30

CASING RECORD:

6-inch

FINISH:

AQUIFERS:

WATER LEVEL:

40-feet

PUMPING EQUIPMENT: Type Berkeley Jet H.P. 2
Capacity 20 G.P.M.

WELL TESTS:

Drawdown 20 ft. after hours Pumping 20 G.P.M.
Drawdown ft. after hours G.P.M.

USE OF WATER Irrigation Temp. °F. 19

SOURCE OF INFORMATION GR-2475
DRILLER or DIGGER A. F. Moody, 370 River Rd., Eugene, Oregon

ADDITIONAL DATA:

Log Water Level Measurements Chemical Analysis Aquifer Test

REMARKS: