

STATE ENGINEER
Salem, Oregon

Well Record **LANE** STATE WELL NO. **18/4W - 3G**
16768 COUNTY **LANE**
APPLICATION NO. **GR-1968**

OWNER: Edward I. Pitkin


MAILING ADDRESS: 2161 Bailey Hill Rd., Rt. 3

LOCATION OF WELL: Owner's No. _____

CITY AND STATE: Eugene, Oregon

SW ¼ NE ¼ Sec. 3 T. 18 N. S., R. 4 E. W., W.M.

Bearing and distance from section or subdivision corner 2940' - S 35° 40' W.

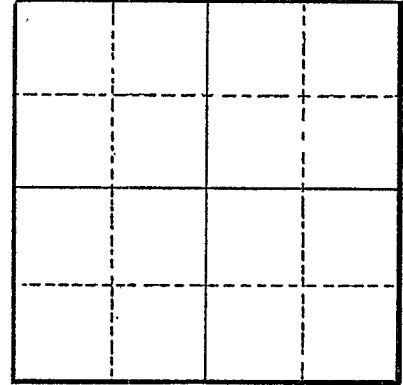

Section _____

Altitude at well _____

TYPE OF WELL: Drilled Date Constructed 1947

Depth drilled 127' Depth cased 80'

CASING RECORD:

5-inch

FINISH:

Not available

AQUIFERS:

Not available

WATER LEVEL:

20'

PUMPING EQUIPMENT: Type Jaccussi Jet Deep Well H.P. 1-½
Capacity 21-½ G.P.M.

WELL TESTS:

Drawdown 40 ft. after _____ hours Pumping 16.66 G.P.M.

Drawdown _____ ft. after _____ hours _____ G.P.M.

USE OF WATER Irrigation Temp. _____ °F. _____, 19_____

SOURCE OF INFORMATION GR-1896

DRILLER or DIGGER Frank C. Gordinier, 2641 Columbia, Eugene, Oregon

ADDITIONAL DATA:

Log _____ Water Level Measurements _____ Chemical Analysis _____ Aquifer Test _____

REMARKS: