

STATE ENGINEER
Salem, Oregon

Well Record

LANE
17262

STATE WELL NO. 18/4W-19N
COUNTY Lane
APPLICATION NO. GR-3139

OWNER: E. E. Burbank


MAILING ADDRESS: Route 3, Box 429

LOCATION OF WELL: Owner's No.

CITY AND STATE: Eugene, Oregon

SW 1/4 SW 1/4 Sec. 19 T. 18 N. S., R. 4 E. W., W.M.

Bearing and distance from section or subdivision
corner South 50° 21' West 1659.97 feet from
NW Corner, H. G. Hadley DLC

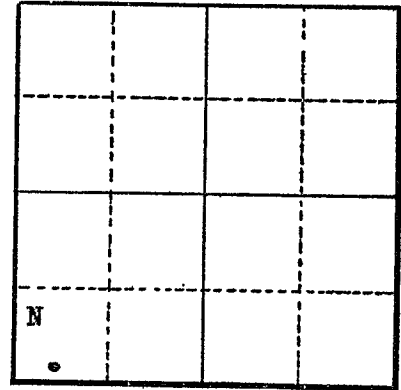

Section 19

Altitude at well 500 feet

TYPE OF WELL: drilled Date Constructed 10-8-50

Depth drilled 84 feet Depth cased 21 feet

CASING RECORD:

6-inch 1/4" steel casing set from 0 to 21 feet

FINISH:

AQUIFERS:

shale

WATER LEVEL:

24 feet

PUMPING EQUIPMENT: Type Fairbanks Morse Jet H.P.
Capacity 20 G.P.M.

WELL TESTS:

Drawdown 20 ft. after hours 20 G.P.M.

Drawdown ft. after hours G.P.M.

USE OF WATER Irrigation Temp. °F. 19

SOURCE OF INFORMATION GR-4013

DRILLER or DIGGER R. E. McTavish, Willow Creek Road, Eugene, Oregon

ADDITIONAL DATA:

Log Water Level Measurements Chemical Analysis Aquifer Test

REMARKS:

Shale 0 to 84