

STATE ENGINEER
Salem, Oregon

LANE Well Record

STATE WELL NO. 18/5W-6E
COUNTY LANE
APPLICATION NO. GR-3904

18071

OWNER: William E. & Lucile Blek


MAILING ADDRESS: Rt. 5 Box 249

LOCATION OF WELL: Owner's No.

CITY AND STATE: Eugene, Oregon

^{SW} 1/4 NW 1/4 Sec. 6 T. 18 S., R. 5 W., W.M.

Bearing and distance from section or subdivision corner 1400' S & 675' E from NW cor Sec. 6

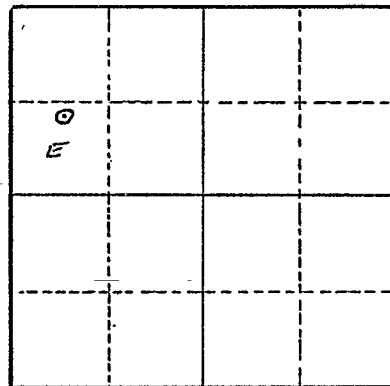

Section 6

Altitude at well

TYPE OF WELL: Drilled Date Constructed 1954

Depth drilled 85' Depth cased 85'

CASING RECORD:

5 3/4"

FINISH:

AQUIFERS:

WATER LEVEL:

50'

PUMPING EQUIPMENT: Type Jet Jacuzzi H.P. 3
Capacity 4000 G.P.M.

WELL TESTS:

Drawdown ft. after hours G.P.M.

Drawdown ft. after hours G.P.M.

USE OF WATER Industrial Temp. °F., 19

SOURCE OF INFORMATION GR-3985

DRILLER or DIGGER Frank Gordinier

ADDITIONAL DATA:

Log NA Water Level Measurements Chemical Analysis Aquifer Test

REMARKS: