

STATE ENGINEER  
Salem, Oregon

LANE

# Well Record

18931

STATE WELL NO. 18/6124D  
COUNTY LANE  
APPLICATION NO. GR-3962

OWNER: Davis A. Patton

MAILING  
ADDRESS: Rt. 1

LOCATION OF WELL: Owner's No.


CITY AND  
STATE: Veneta, Oregon

NW 1/4 NW 1/4 Sec. 24 T. 18 S., R. 6 W., W.M.

Bearing and distance from section or subdivision

corner 2.5 chs S & 12 chs E of NW cor Sec 24

T18S, R6W

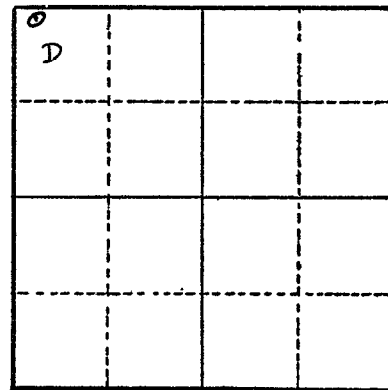

Section 24

Altitude at well

TYPE OF WELL: Drilled Date Constructed 1955

Depth drilled 80' Depth cased 50'

CASING RECORD:

6-inch

FINISH:

AQUIFERS:

WATER LEVEL:

30'

PUMPING EQUIPMENT: Type F.M. & Co Deepwell Jet H.P. 2  
Capacity 35 G.P.M.

WELL TESTS:

Drawdown 5 ft. after hours 60 G.P.M.

Drawdown ft. after hours G.P.M.

USE OF WATER Irrigation Temp. °F., 19

SOURCE OF INFORMATION GR-3872

DRILLER or DIGGER

ADDITIONAL DATA:

Log NA Water Level Measurements Chemical Analysis Aquifer Test

REMARKS: