

STATE ENGINEER  
Salem, Oregon


Well Record  
19010

LANE

STATE WELL NO. 18/8W-18C  
COUNTY Lane  
APPLICATION NO.

MAILING ADDRESS: Lane County, Lane County Parks and Recreation Department  
CITY AND STATE: Eugene, Oregon

NE 1/4 NW 1/4 Sec. 18 T. 18 S., R. 8 W., W.M.  
Bearing and distance from section or subdivision corner N58°31'06"W. 2183.74 ft. to the NW cor. of section 18.

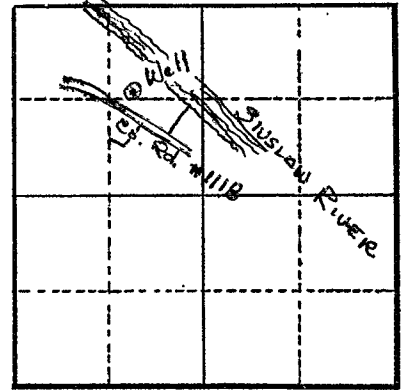

Section 18

Altitude at well 250 ft.

TYPE OF WELL: Drilled Date Constructed  
Depth drilled 220 ft. Depth cased

CASING RECORD:

FINISH:

AQUIFERS:

WATER LEVEL:

PUMPING EQUIPMENT: Type Jacuzzi H.P. 3  
Capacity G.P.M.

WELL TESTS:  
Drawdown ft. after hours G.P.M.  
Drawdown ft. after hours G.P.M.

USE OF WATER Dom. & Public Park Temp. °F., 19

SOURCE OF INFORMATION Related registration statement

DRILLER or DIGGER

ADDITIONAL DATA:

Log Water Level Measurements Chemical Analysis Aquifer Test

REMARKS: