

STATE ENGINEER
Salem, Oregon

Well Record

LANE

STATE WELL NO. 19/1W-6G

COUNTY Lane

APPLICATION NO. GR-1329

GR- 1284

019506

OWNER: Robert I. Swan

MAILING

ADDRESS: Star Route

CITY AND


STATE: Dexter, Oregon

LOCATION OF WELL: Owner's No.

SW $\frac{1}{4}$ NE $\frac{1}{4}$ Sec. 6 T. 19 S., R. 1 W., W.M.

Bearing and distance from section or subdivision

corner

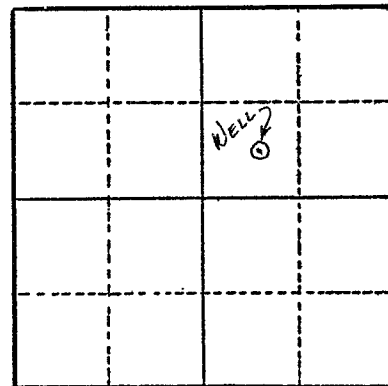

Section 6

Altitude at well 200 ft.

TYPE OF WELL: Dug Date Constructed 1954

Depth drilled 12 ft. Depth cased 12 ft.

CASING RECORD:

72in. wood

FINISH:

AQUIFERS:

WATER LEVEL:

6 ft.

PUMPING EQUIPMENT: Type Berkeley Cent. H.P. 10

Capacity G.P.M.

WELL TESTS:

Drawdown ft. after hours G.P.M.

Drawdown ft. after hours G.P.M.

USE OF WATER Irrigation Temp. °F., 19

SOURCE OF INFORMATION G. R. Record

DRILLER or DIGGER

ADDITIONAL DATA:

Log Water Level Measurements Chemical Analysis Aquifer Test

REMARKS:

Log: Sandy loam 0 to 6 ft.
Small rock 6 to 12 ft.

Irrigation of 18 acres.